
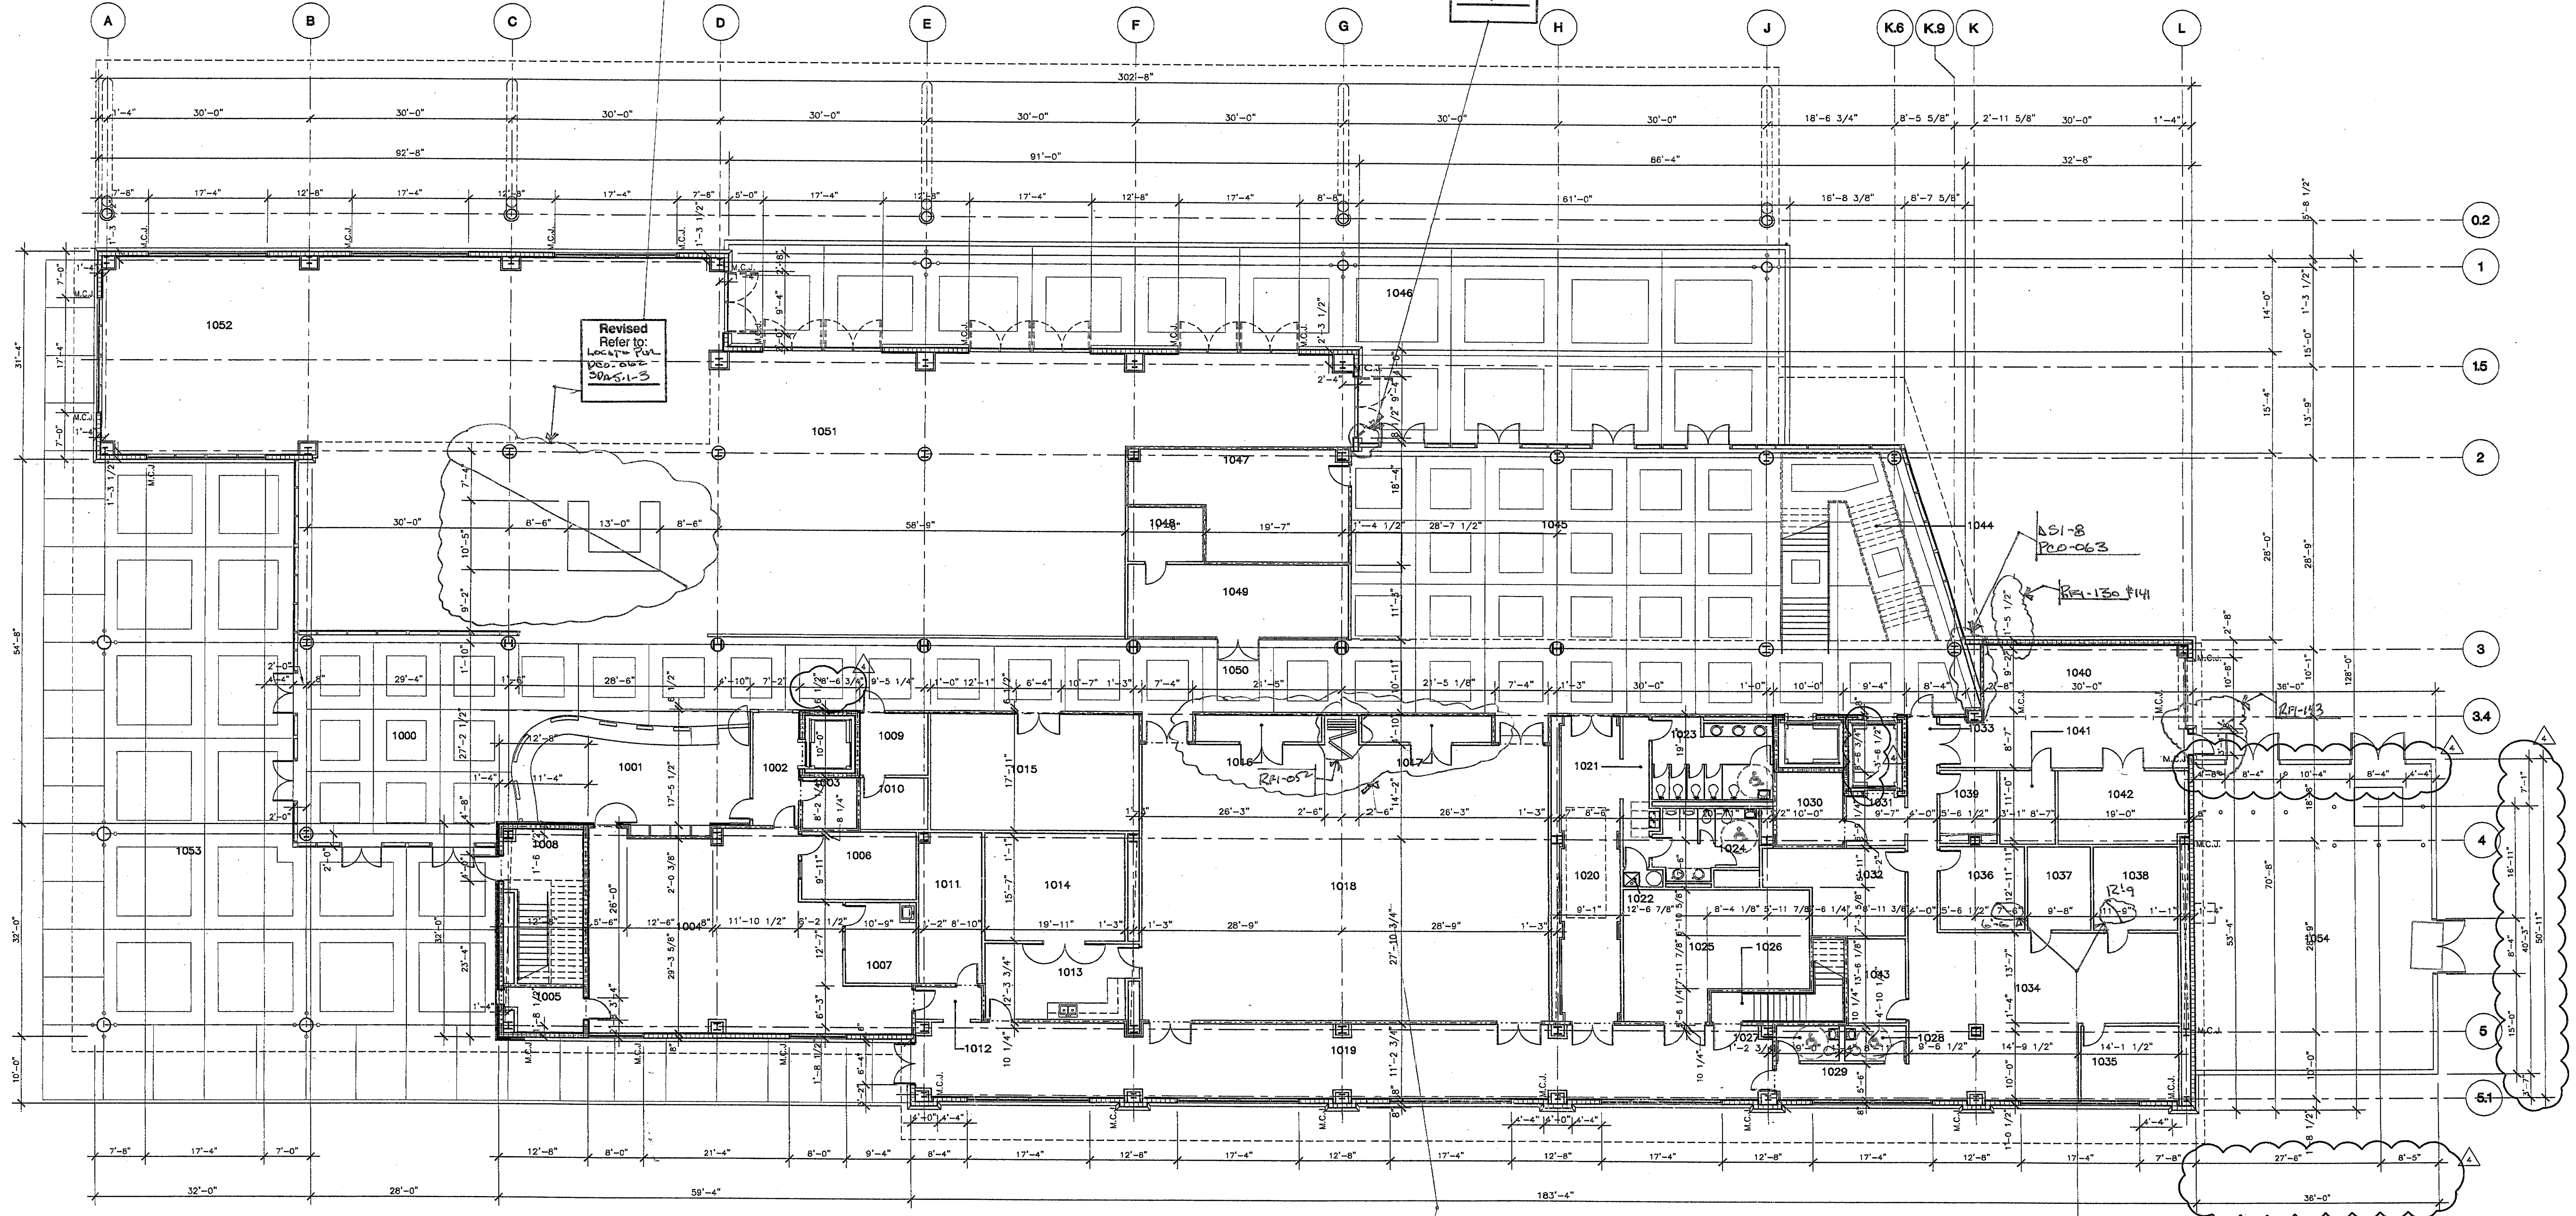


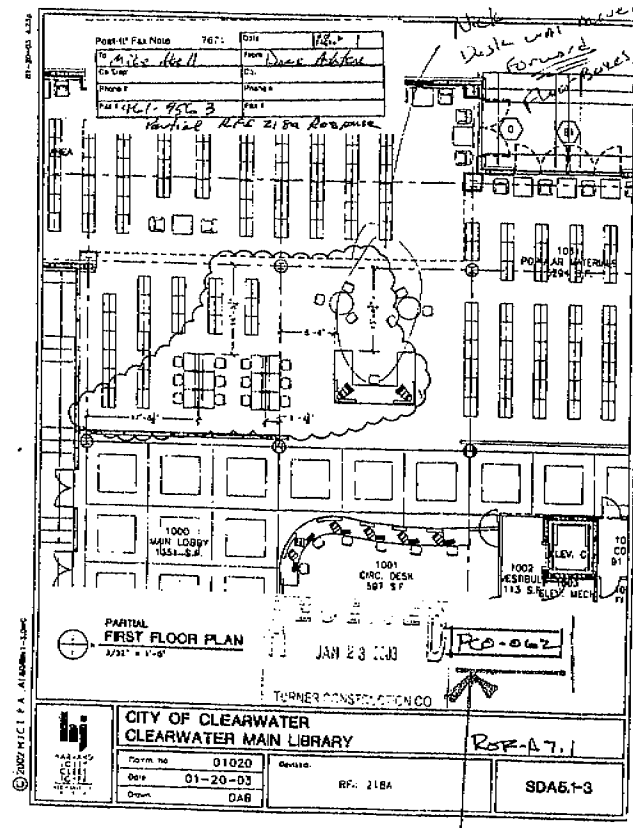



Record Set

Turner Construction
Clearwater Library Project
PCO #011 27 Sept 02
Revision (4)


**DIMENSION
FIRST FLOOR PLAN**

3/32" = 1'-0"
0 4' - 8' 24'

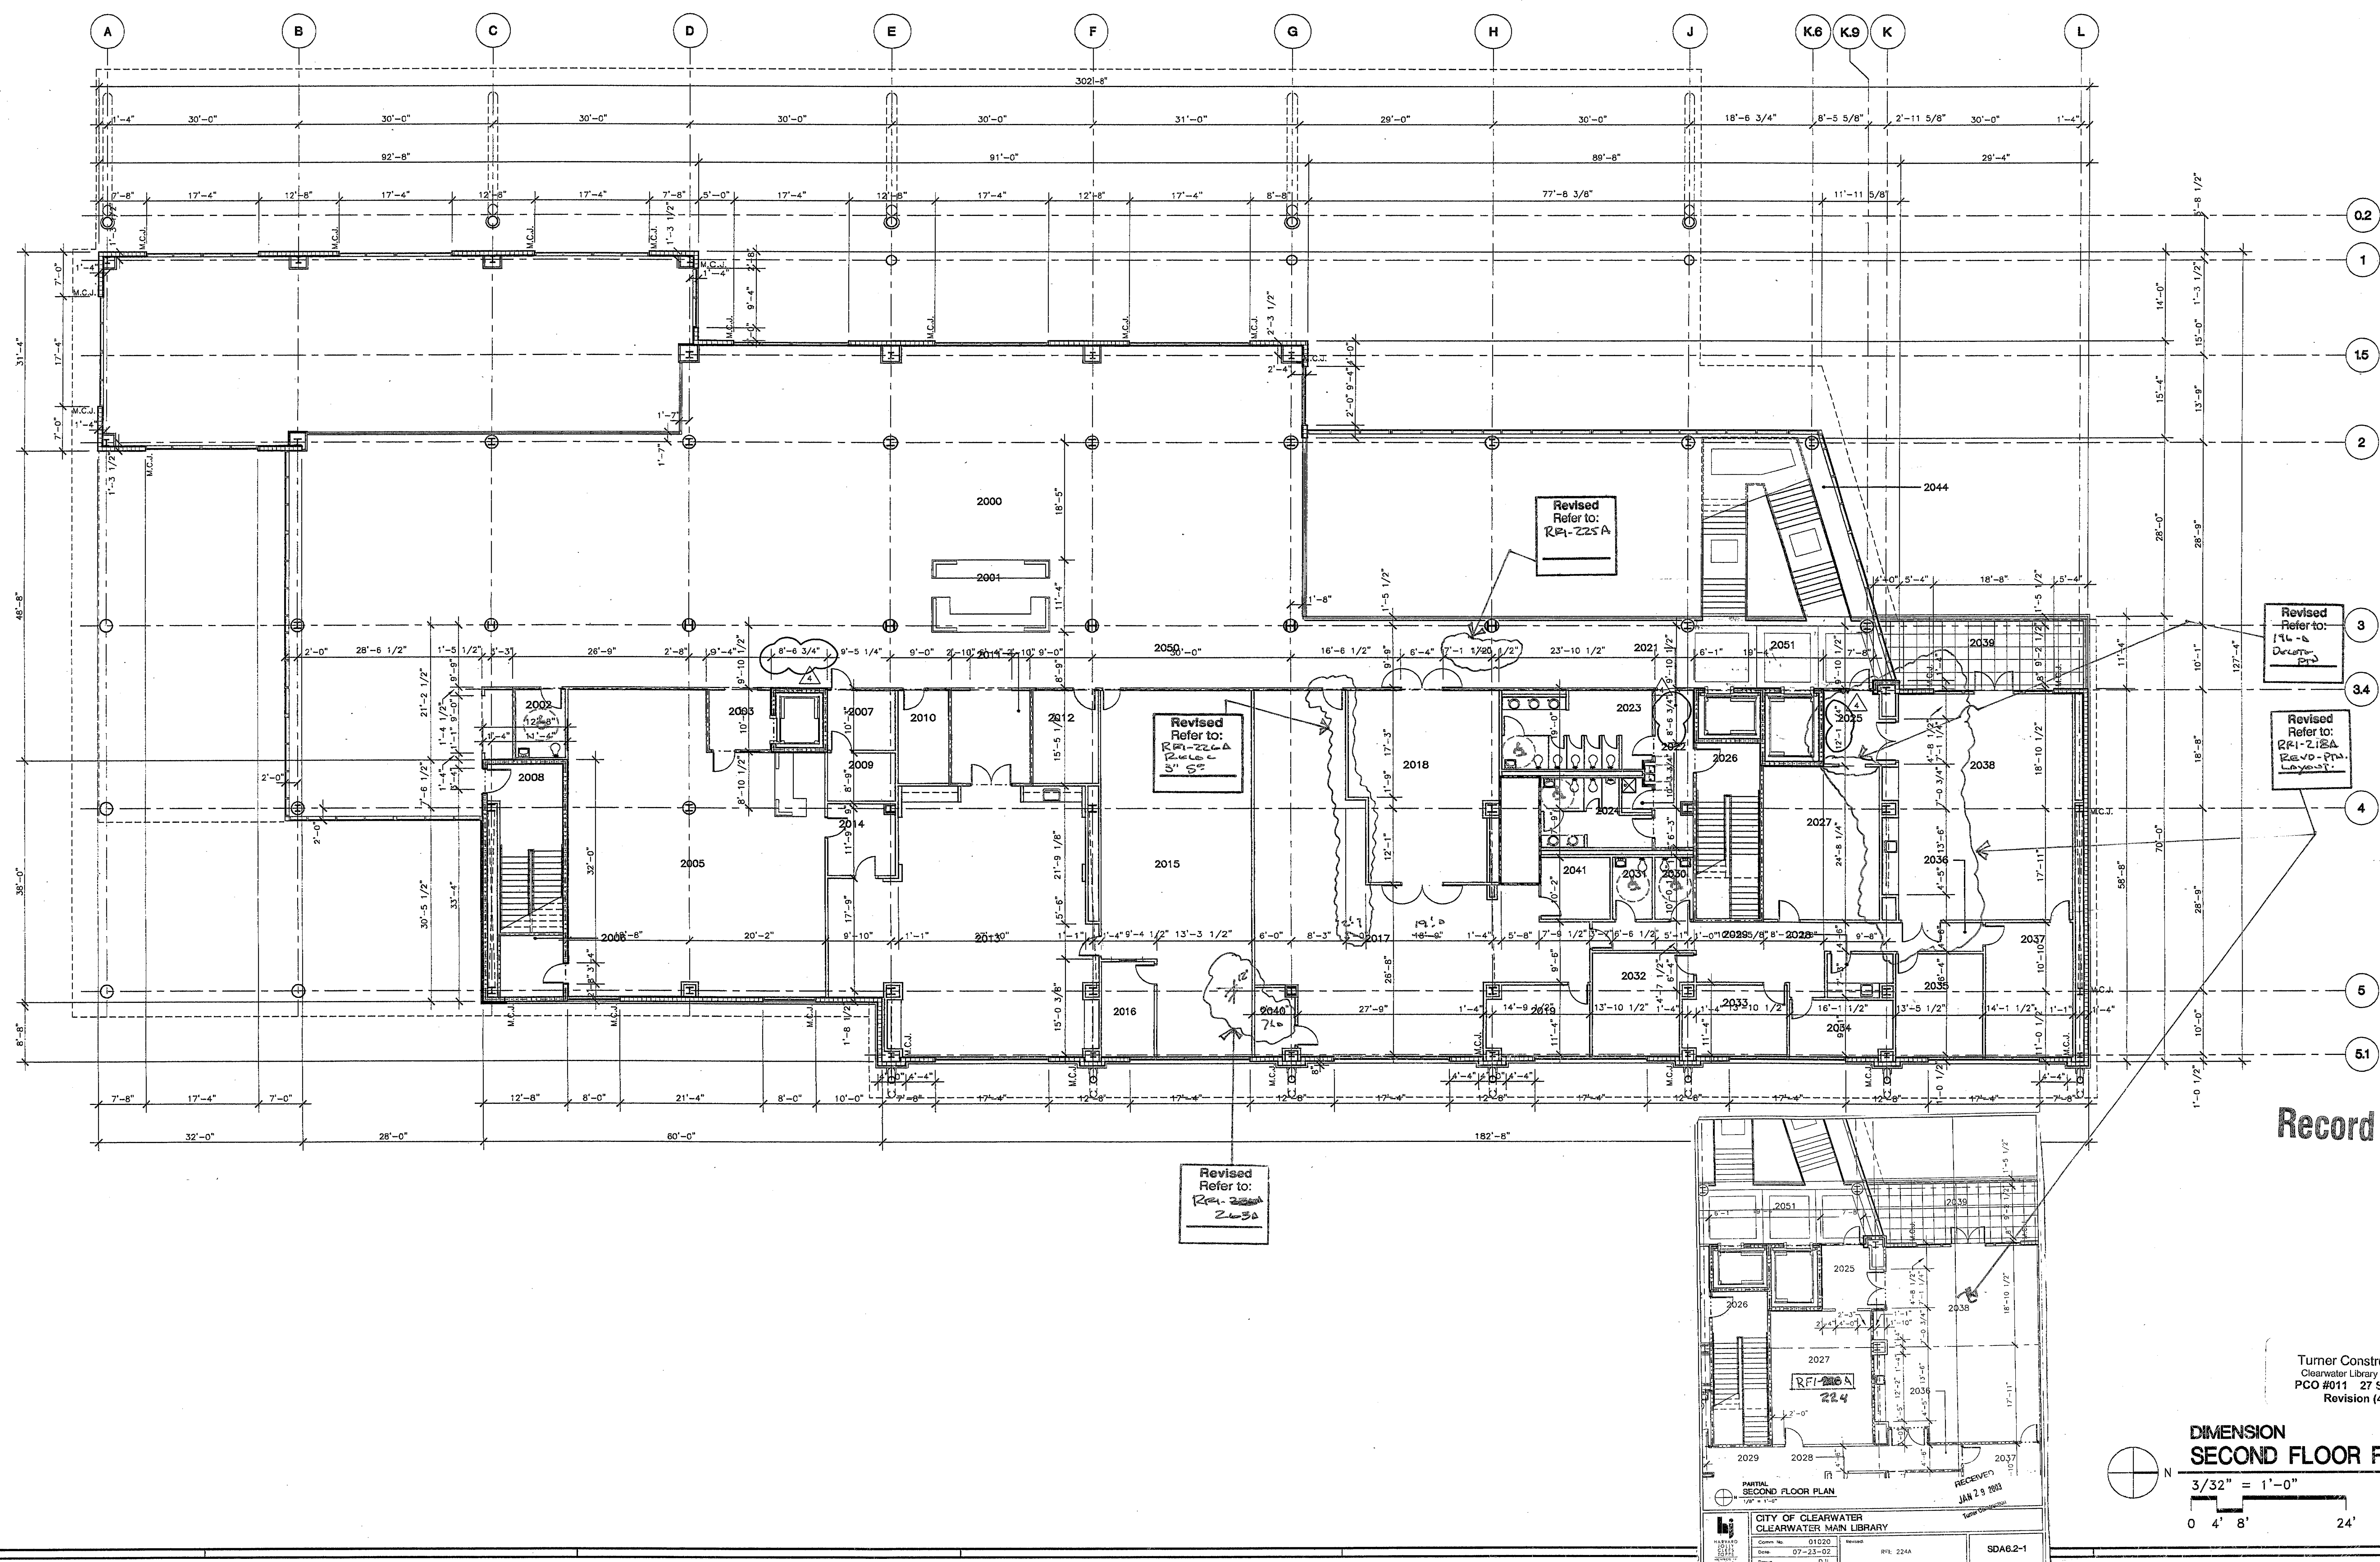

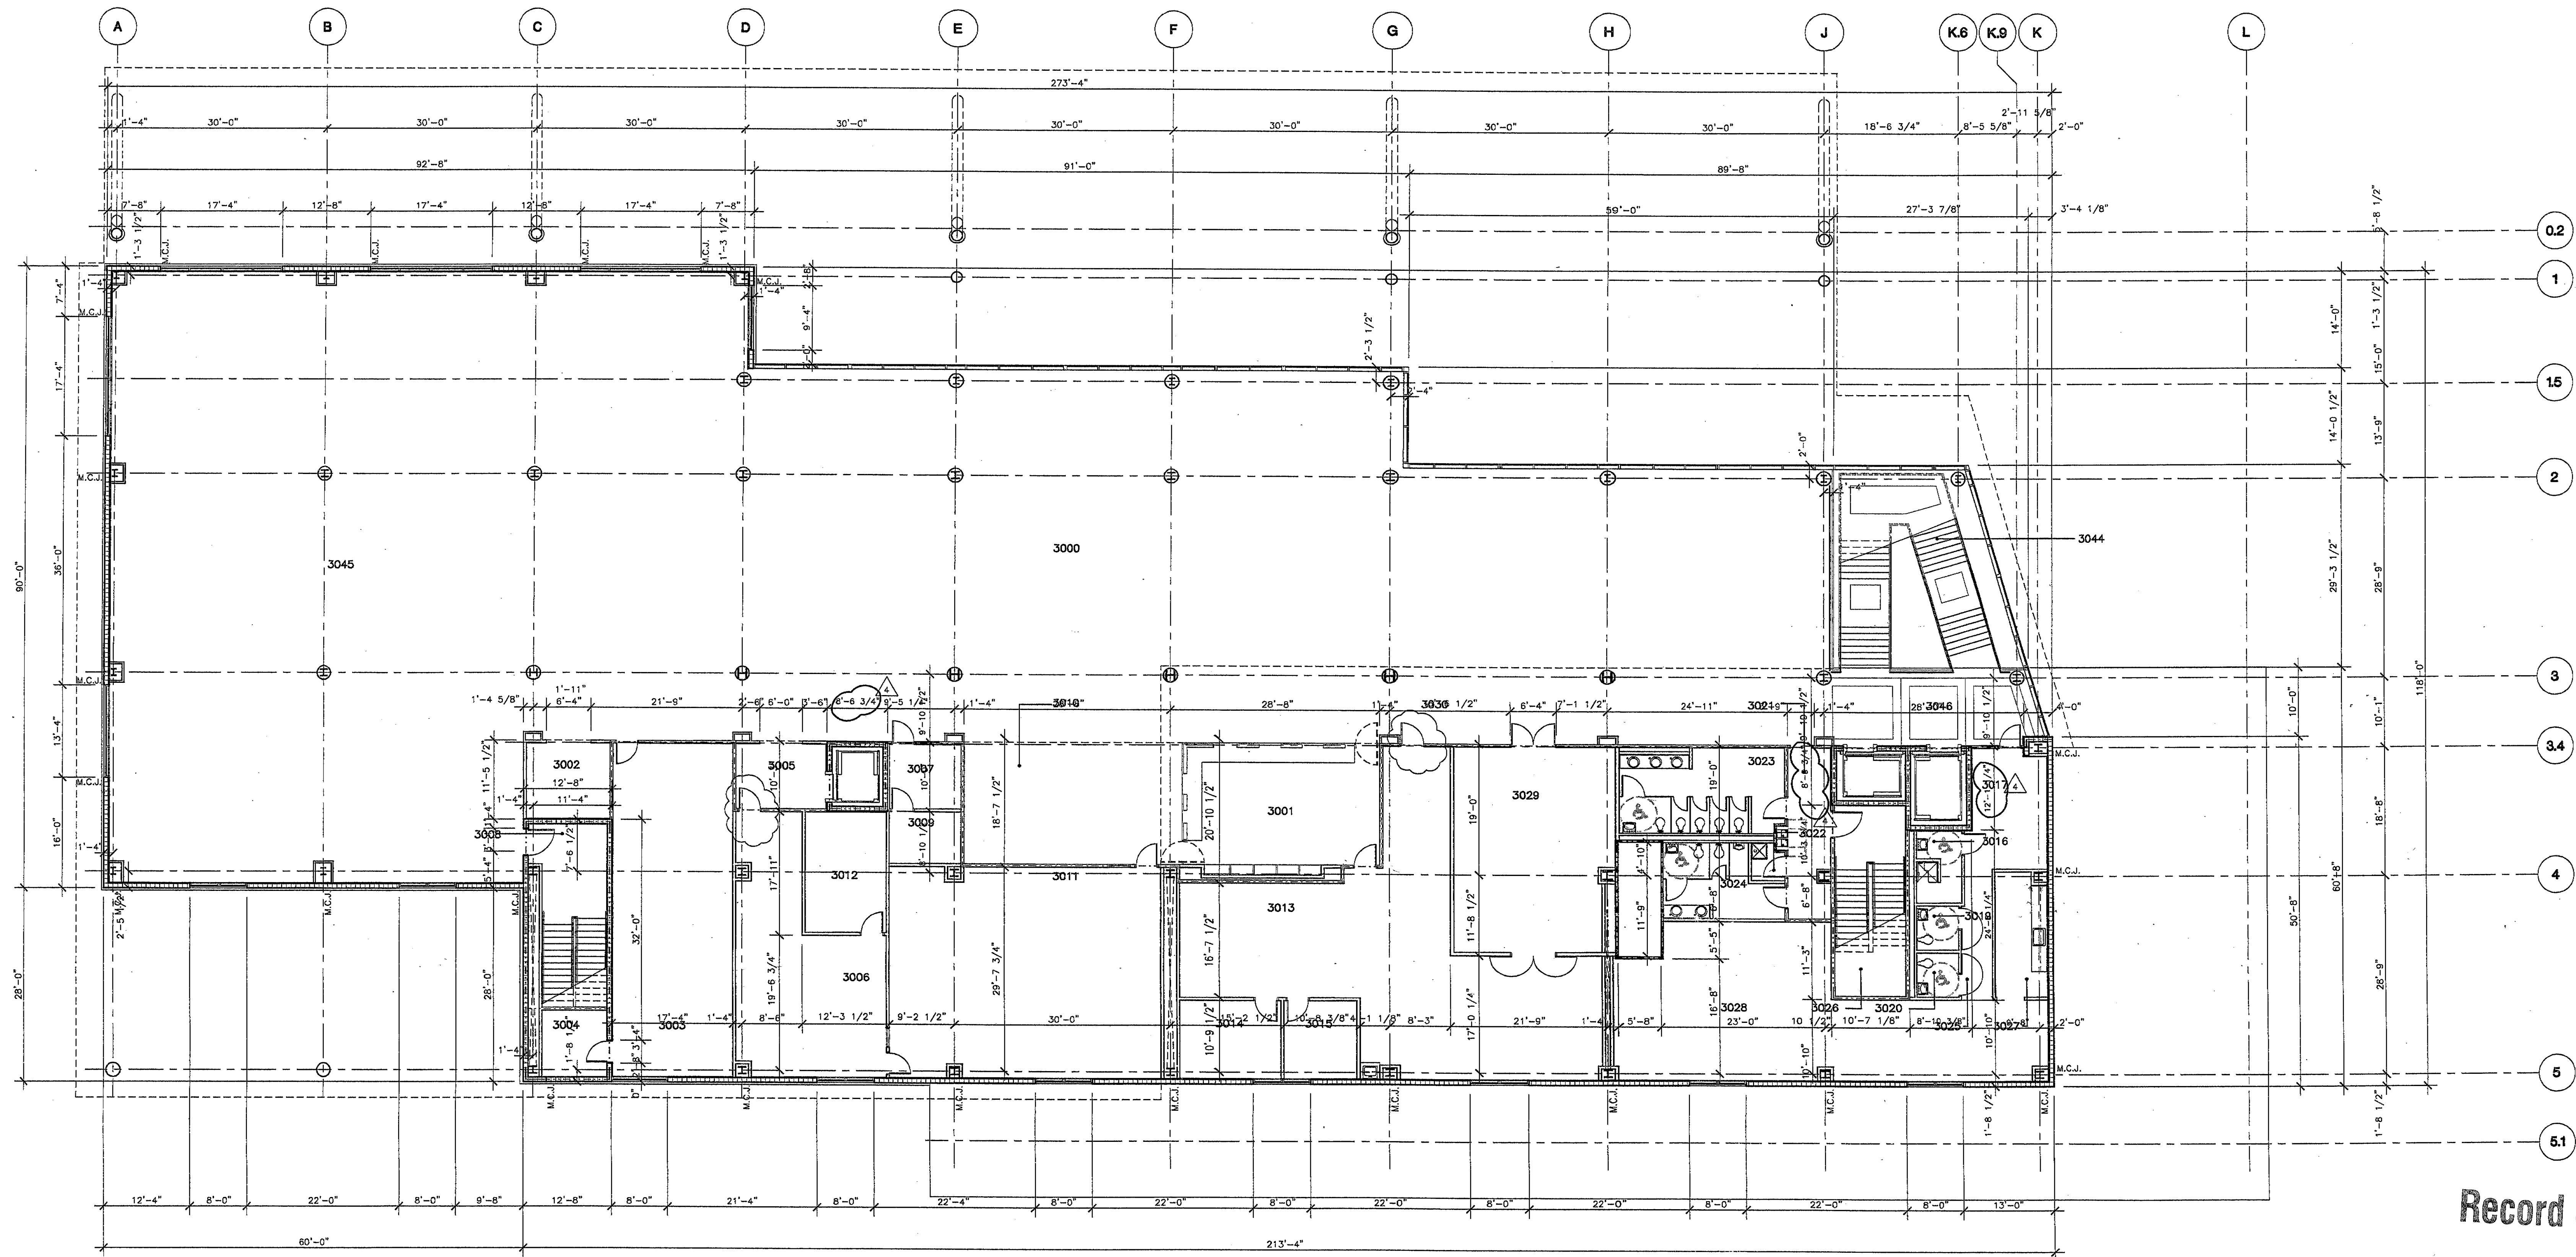


Record Set

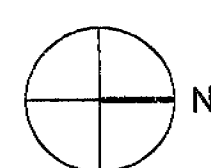

DIMENSION
THIRD FLOOR PLAN


3/32" = 1'-0"
0 4' 8' 24'

Turner Construction
Clearwater Library Project
PCO #011 27 Sept 02
Revision (4)

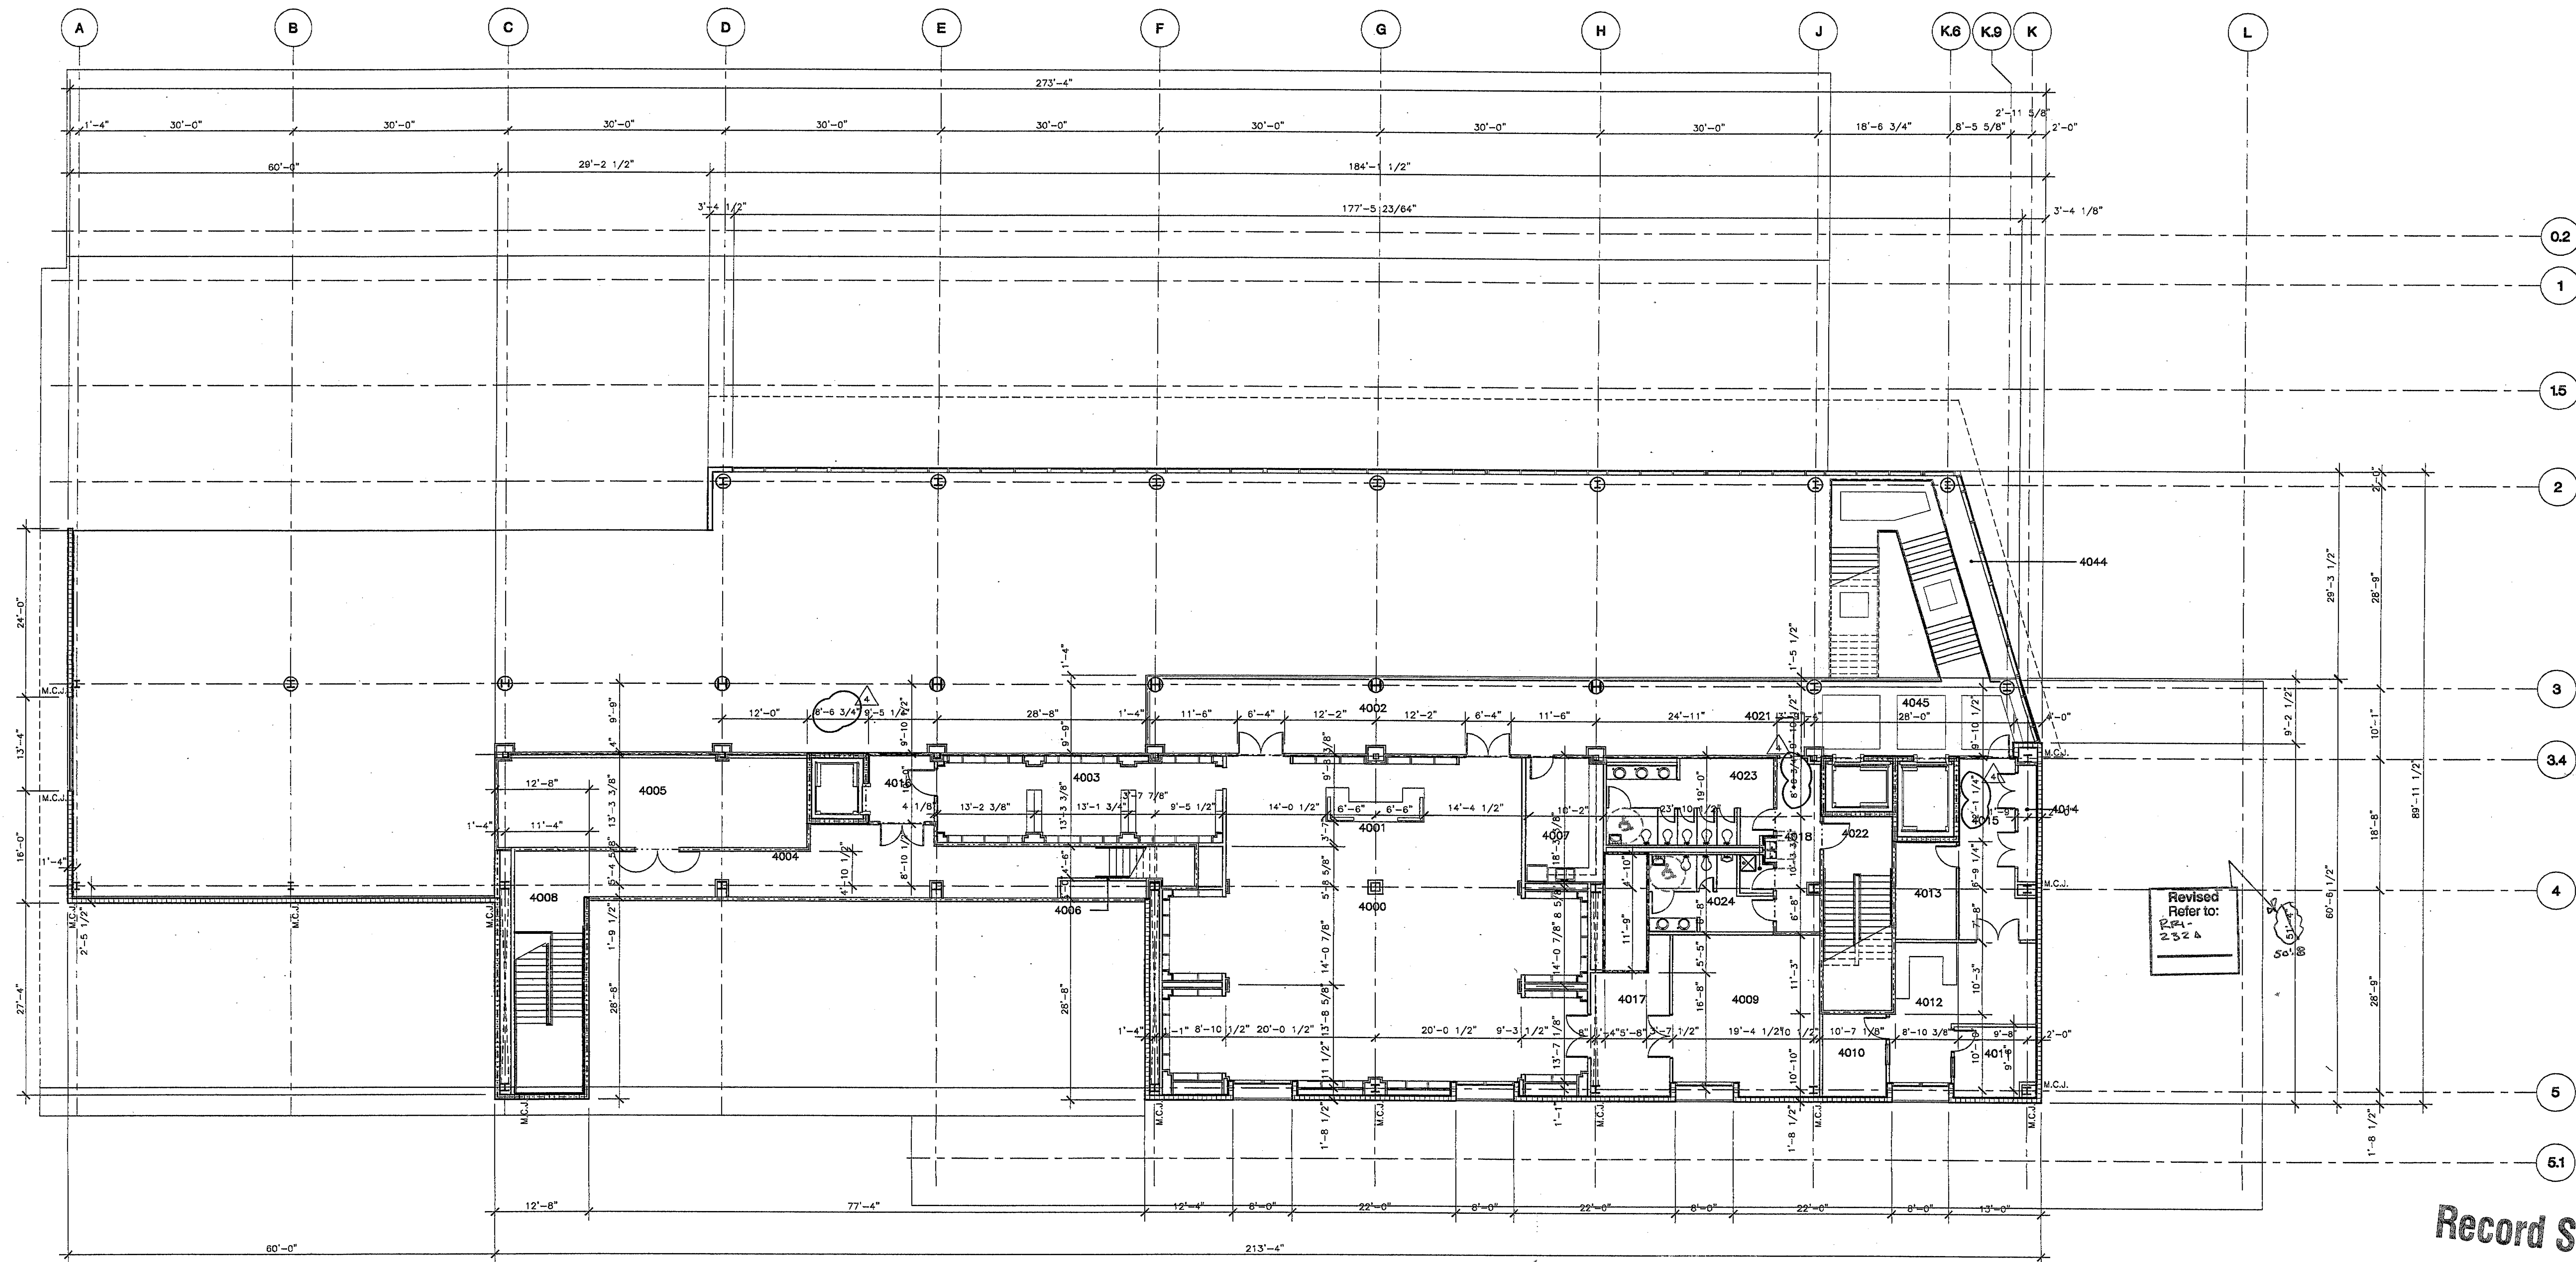

Record Set

Turner Construction
Clearwater Library Project
PCO #011 27 Sept 02
Revision (4)

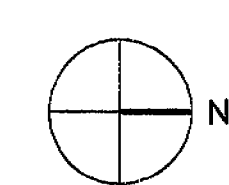


DIMENSION
FOURTH FLOOR PLAN


3/32" = 1'-0"
0 4' 8' 24'

12-18-01 4:11P

FN:30A06-5-01020.DWG

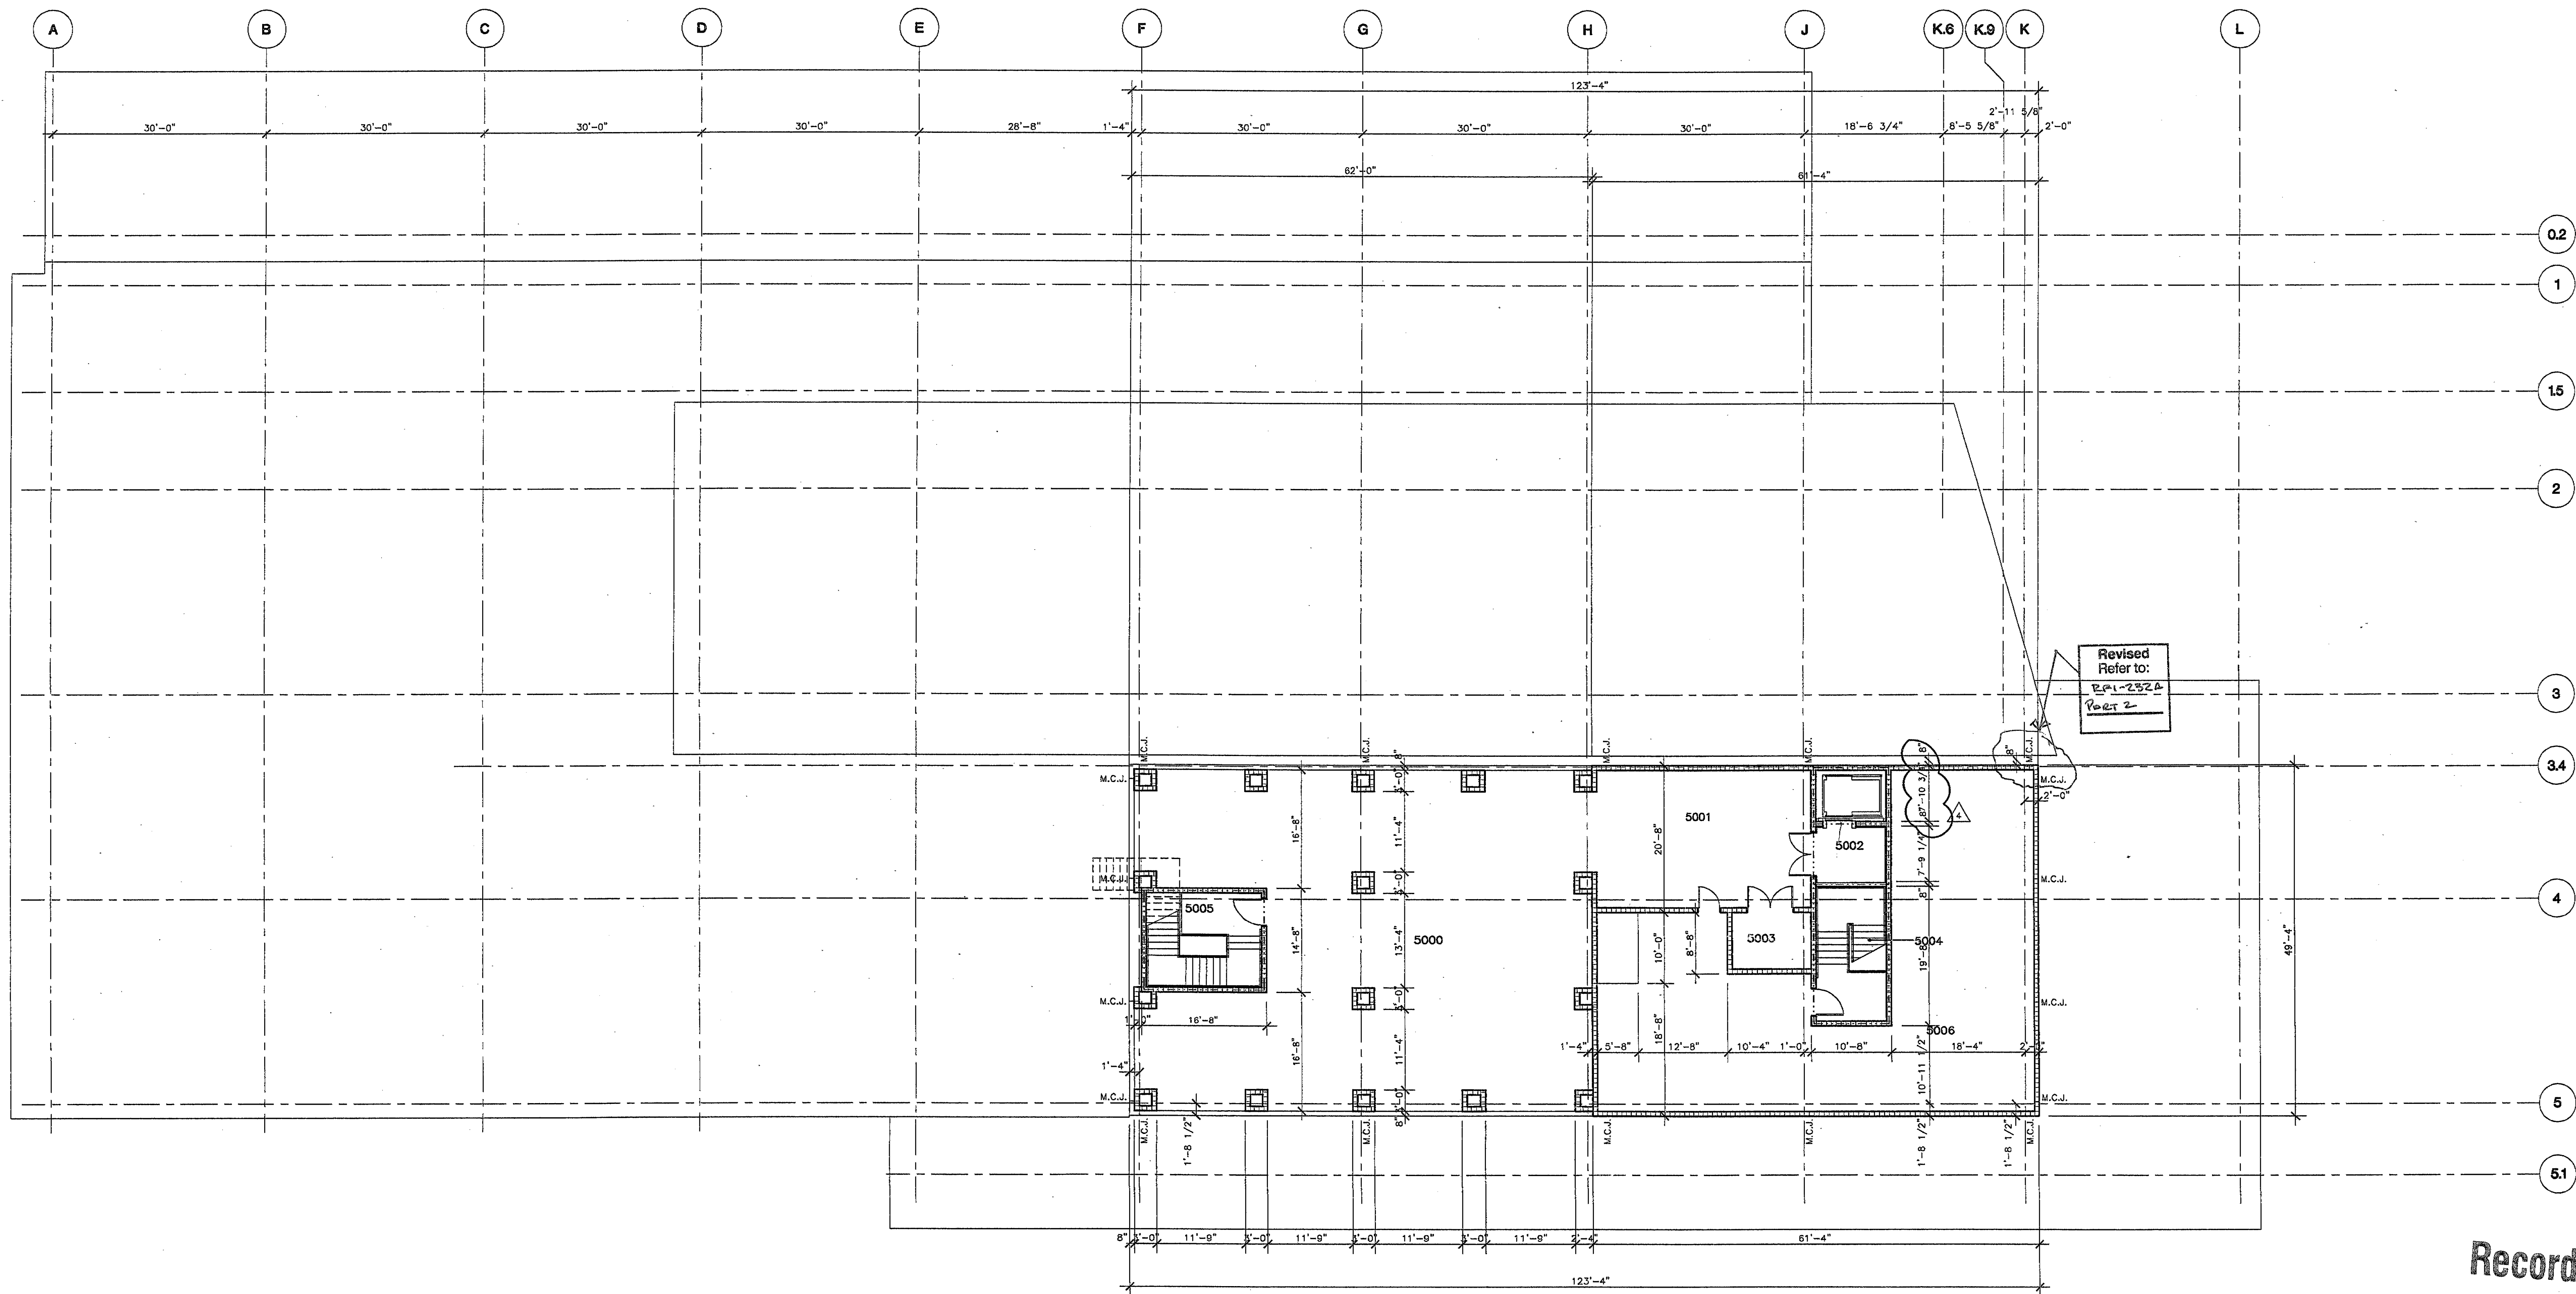

Record Set

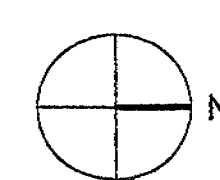

**DIMENSION
PENTHOUSE FLOOR PLAN**

3/32" = 1'-0"
0 4' 8' 24'

Turner Construction
Clearwater Library Project
PCO #011 27 Sept 02
Revision (4)

44

hj
HARVARD
JOLLY
CLEES
TOPPE
ARCHITECTS, P.A.
A I A
2714 Ninth St. N.
St. Petersburg, FL
33704
727/896 4611
AA C000119

DESIGN ARCHITECT
ROBERT A.M. STERN ARCHITECTS
400 WEST 94th STREET, NEW YORK, NY 10001
TEL (212) 987-5100 • FAX (212) 987-5555

**CITY OF CLEARWATER
CLEARWATER MAIN LIBRARY**
100 NORTH OSCEOLA AVENUE, CLEARWATER, FL 33755
100% CONSTRUCTION DOCUMENTS

Comm. No. 01020
Date 07-23-02
Drawn:
Revised:
09-02-02

©2002 HJCT, P.A., AIA

A6.5